


122 x 15

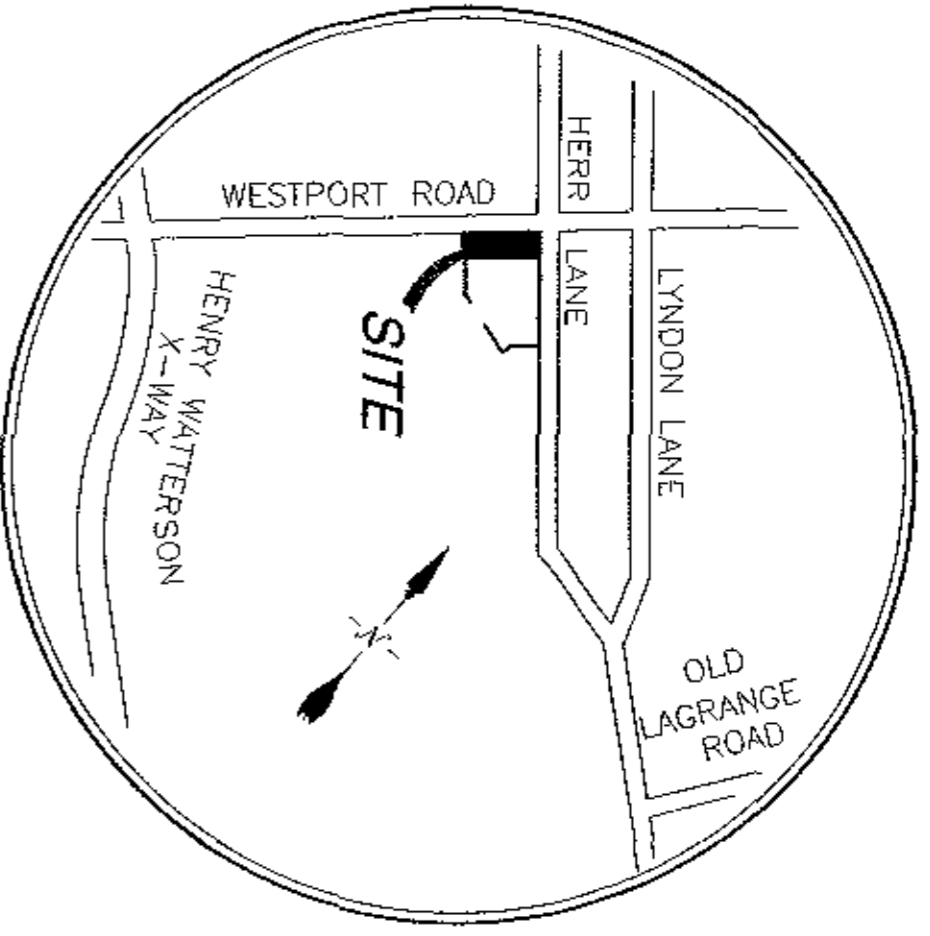


CATHERINE M. WHITENHOUSE
DB 6155, PG. 295
R-4

GRAYMOOR ESTATES PATIO HOMES
DB 7788, PG. 203
DB 6504, PG. 484
FB 93, PG. 32
R-5A

AUGUSTINE A. TRAXELL
DB 4390, PG. 152
R-4

CHUN K. & KWAI H. WONG
DB 7426, PG. 537
R-4

91 x 221

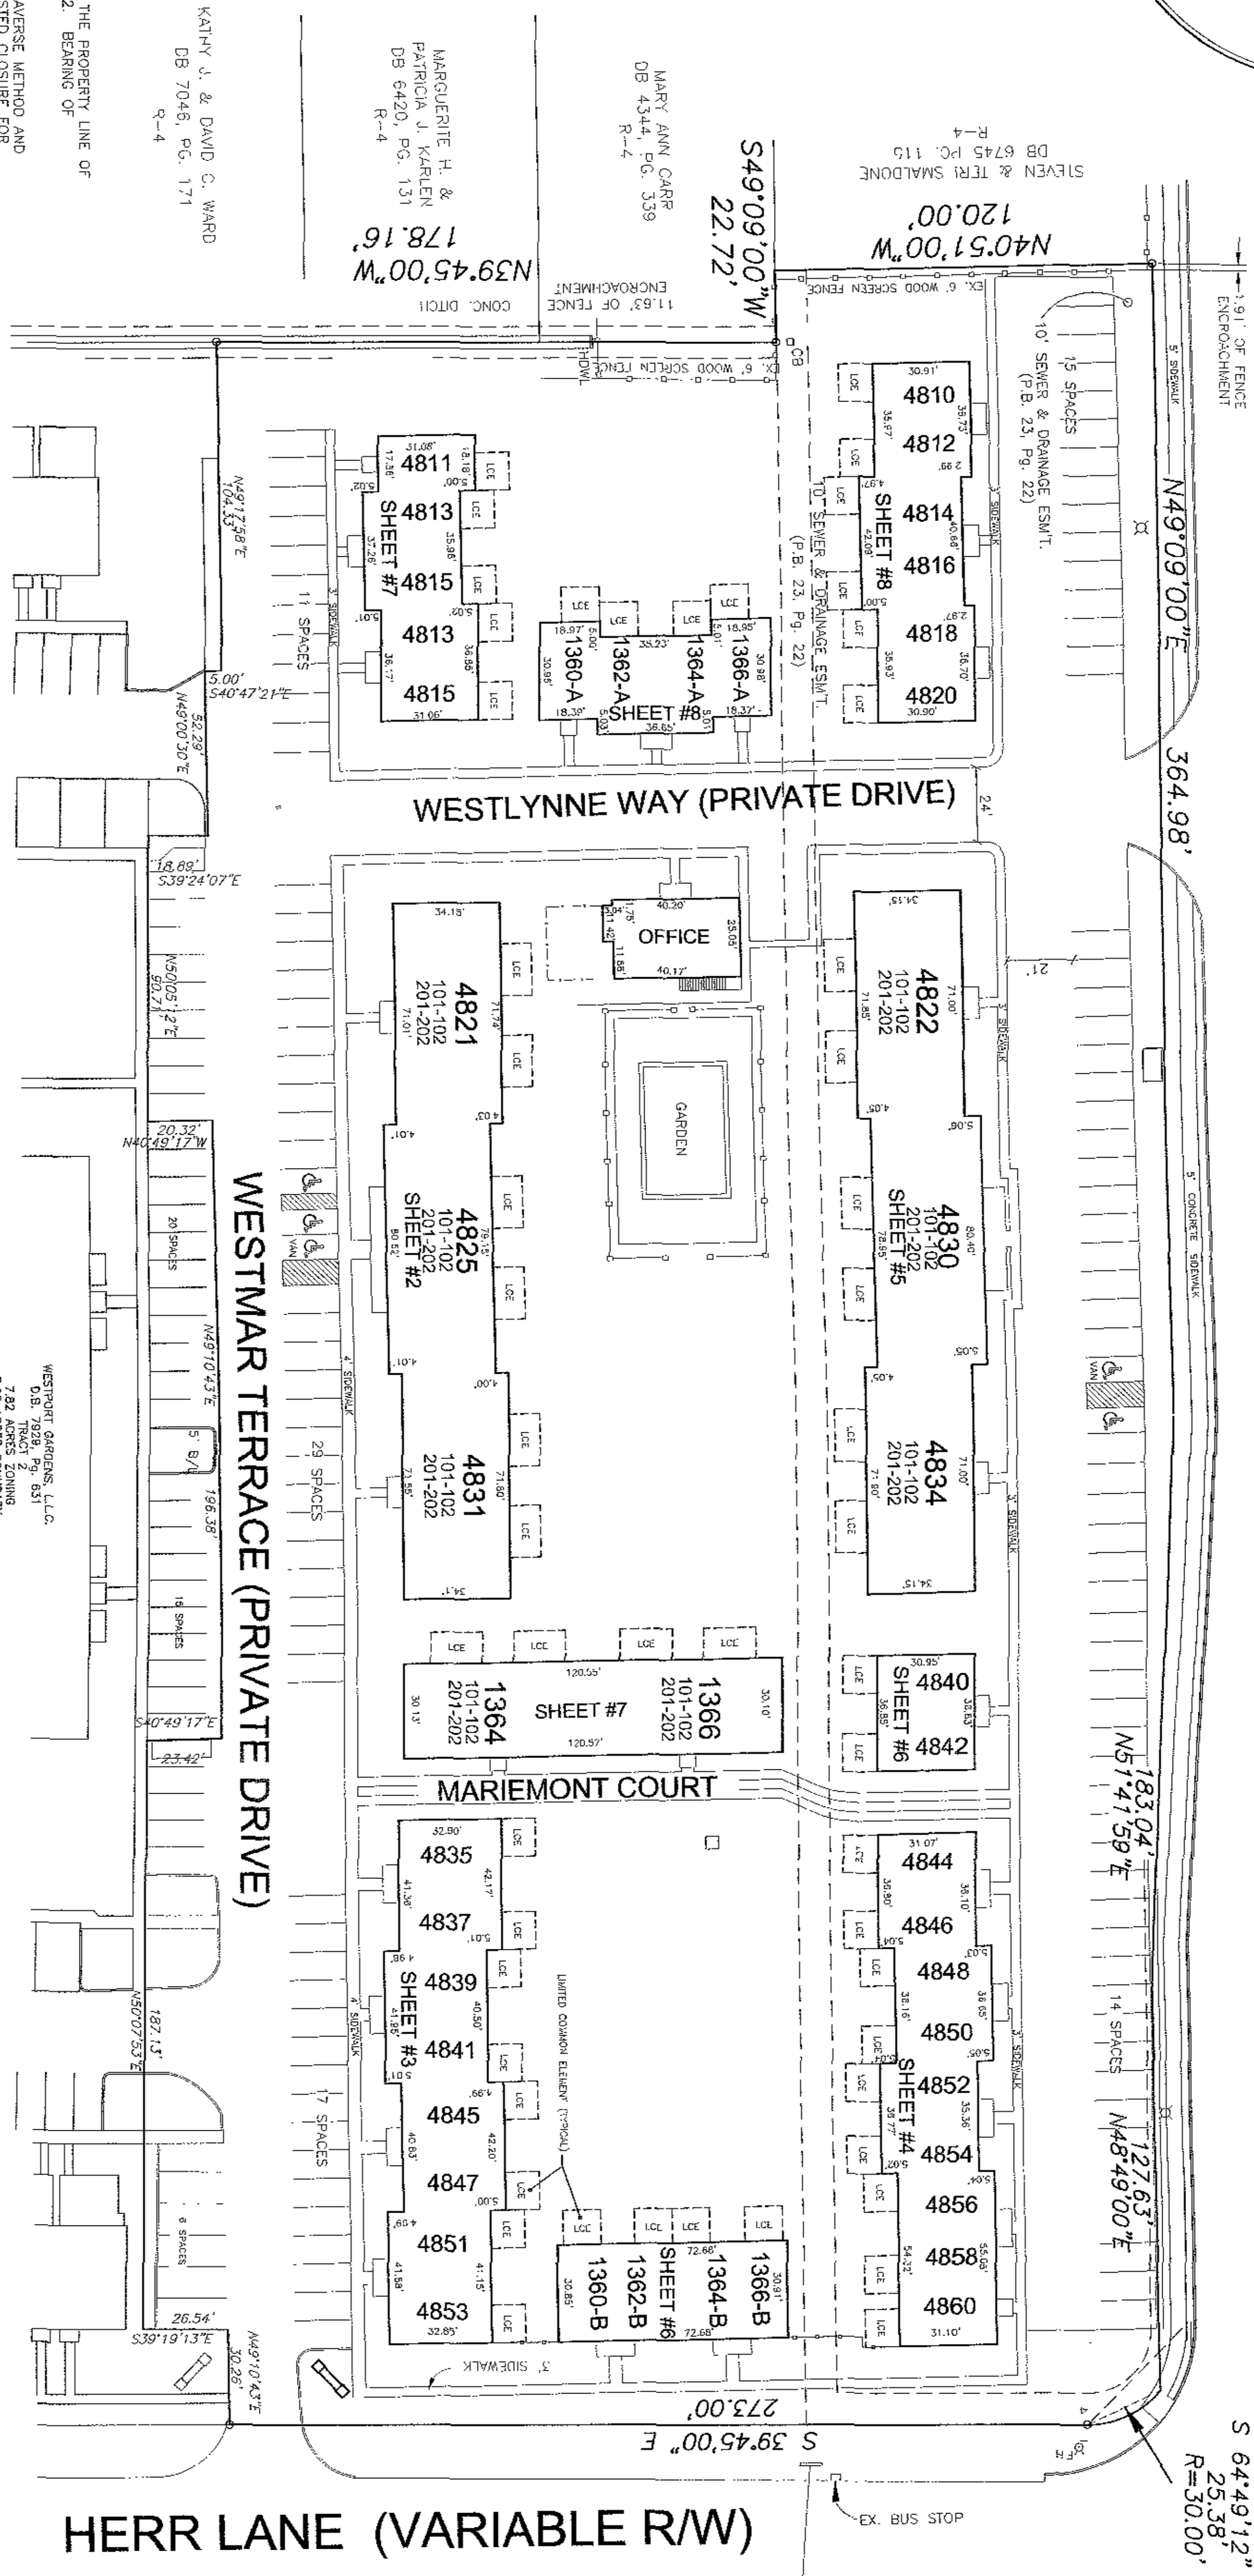

NOTES
THE REFERENCE MERIDIAN FOR THIS PROPERTY IS THE PROPERTY LINE OF HERR LANE RECORDED IN PLAN BOOK 23, PAGE 22. BEARING OF S 39°45'00" E.
THE SURVEY WAS CONDUCTED BY THE RANDOM TRAVERSE METHOD AND HAS BEEN ADJUSTED FOR CLOSURE. THE UNADJUSTED CLOSURE FOR THIS TRACT IS 1 PART IN 18,831.69 FEET.
THIS SURVEY IS SUBJECT TO ALL LEGAL ROADWAYS, EASEMENTS, AND RIGHT-OF-WAY, IF ANY, WHETHER SHOWN HEREON OR NOT.

KATHY J. & DAVID C. WARD
DB 7046, PG. 171
S-4

MARY ANN CARR
DB 4344, PG. 339
R-4

MARGUERITE H. & PATRICIA J. KARLEN
DB 6420, PG. 131
R-4

THIS PROPERTY IS LOCATED IN ZONE "X" AS SHOWN ON COMMUNITY PANEL NUMBER 210123 0085D (CITY OF ST. MATHEWS), DATED 02 FEB. 1984, OF THE FLOOD INSURANCE RATE MAP, AND IS NOT SHOWN IN A 100 YEAR FLOOD HAZARD AREA.

ALL CONDOMINIUM UNITS, AS SHOWN ON THE FOLLOWING SHEETS, WERE ASSUMED TO BE SQUARE AND PLUMB FOR UNIT MEASUREMENTS.

ALL PARKING, SIDEWALKS, AND INGRESS AND EGRESS ROUTES ARE CONSIDERED TO BE GENERAL COMMON ELEMENTS.


NOTARY'S CERTIFICATE
I, CHERYL L. MATHERLY, A NOTARY PUBLIC IN THE COMMONWEALTH OF KENTUCKY, DO HEREBY CERTIFY THAT THIS PLAN WAS PRESENTED KNOWINGLY TO ME, WHO EXECUTED THE ABOVE CERTIFICATE IN MY PRESENCE, AND ACKNOWLEDGED IT TO BE MY FREE ACT AND DEED.

NOTARY PUBLIC
CHERYL L. MATHERLY
07/16/2006

MY COMMISSION EXPIRES 07/16/2010

SUPERVISOR'S CERTIFICATE
I, AL L. MATHERLY, A PROFESSIONAL LAND SURVEYOR IN THE STATE OF KENTUCKY, DO HEREBY CERTIFY THAT THIS SURVEY WAS MADE, BY ME, IN ACCORDANCE WITH THE REQUIREMENTS OF THE SURVEYING ACT AND MEASUREMENTS OF THE CONDOMINIUM UNITS AND IMPROVEMENTS FULLY AND ACCURATELY DEPICT THE LAYOUT, LOCATION, LIMIT NUMBERS, AND DIMENSIONS OF THE UNITS AS BUILT AS REQUIRED BY KRS 381.83, AMENDED 1988 KY ACTS CH. 214, SEC. 41.

AL L. MATHERLY
2179
10/04/2007
Date

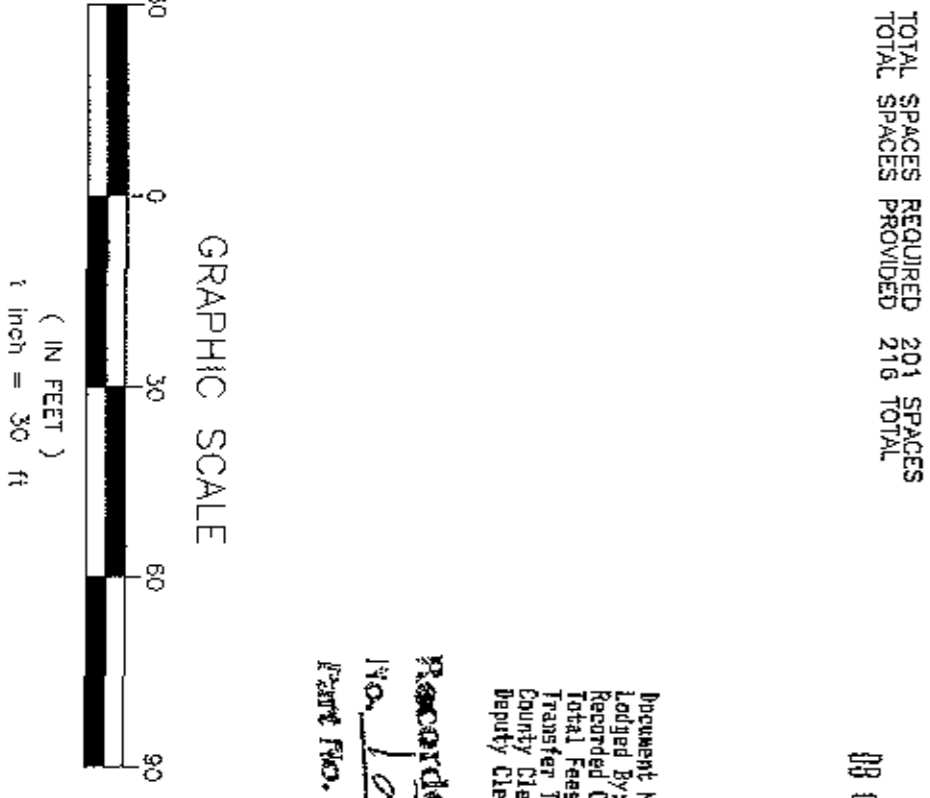

WESTPORT GARDENS, LLC
DB 7929, PG. 631
7.95 ACRES ZONING R-7 DISTRICT
TOTAL SPACES REQUIRED 201 SPACES
08 09 11 7 PG 04 62

Recorded in Condo Book
122 x 15
15

SECOND AMENDMENT
THE COMMONS OF
WESTPORT GARDENS
CONDOMINIUMS

WESTPORT GARDENS APARTMENTS, LLC
1365 WESTLYNNE WAY
LOUISVILLE, KENTUCKY 40222

MATHERLY
LAND
CONSULTANTS
1302 TROON WAY
LOUISVILLE, KY 40213
(502) 484-8020
(502) 484-8010 Fax

SCALE: 1" = 30'
DRAWN BY: ALK
SURVEY DATE: 10/17-19/2005
REVISION ADDRESSES: 11/03/06 12/04/06
REVISION: PATIOS 08/23/2007

DATE: 10/20/2005
REVIEWED BY: ALK

OF 1
05790

122 x 15

122 x 15

ARCH L. & HIGHLA HADY
DB 3704, PG. 375
OH: 1